

University of North Carolina at Charlotte, North Carolina  
**SANITARY SEWER REPAIR AND REPLACEMENT (SOUTH VILLAGE)**

**To:** All Holders of Contract Documents

**Subject:** Addendum No. 3

Please make the following revisions/changes to the contract documents:

**Contract Documents**

1. REVISE the Advertisement for Bid, bid due date to April 16, 2026. Note the bid opening will be held in FMPPS Room 119.
2. REVISE the Notice to Bidders, bid due date to April 16, 2026.

**Contract Drawings**

1. Sheet C-108. Existing 6" DIP water line (fire service) added to plans.

**Attachments to Addendum 3.**



1. Sheet C-108.

**END OF ADDENDUM 3**




- GENERAL NOTES**
- ALL DISTURBED AREAS ARE TO BE RESTORED TO ORIGINAL CONDITIONS, UNLESS INDICATED OTHERWISE.
  - ASSOCIATED WITH SCOTT HALL BUILDINGS FOOTINGS FROM RECORD DRAWING ENTITLED "FOUNDATION FOR SCOTT HALL BUILDING HALL 12" DATED 7/12/1971. RESTORE STOCKPILED RIP RAP ON FINISHED HALL 12 AS DIRECTED BY THE ENGINEER.

- RRAP SLOPE NOTES**
- APPROXIMATE RIBBON AND PROVIDE SUPPLEMENTAL STONE TO ACHIEVE COMPLETE TABLET COVER FOR THE CLASH SHOWN ON THE PLANS, UNLESS NOTED OTHERWISE. USE RIP MAX 12 IN. B MIN 5 IN., MIDRANGE 8 IN.
  - PROVIDE GEOTEXTILE, TYPE 2 IN ACCORDANCE WITH M888, OVERLAP SEAMS 18 IN. MIN. (WOVEN OR NONWOVEN, PROPERTIES PER ASHTO M888). OVERLAP SEAMS 18 IN. MIN. FROM TOP TO BOTTOM. PROVIDE GEOTEXTILE LAST TO PREVENT DISPLACEMENT, AND PROTECT FROM UP PRIOR TO COVER. PATCH ANY DIRECTIONS.
  - GRADE AND COMPACT THE SLOPE TO LINE/GRADE. REMOVE PROTRUSIONS, CORNING TOP EDGE AND KEENING AT THE TOE.
  - PLACE RRAP TO A COMPACTED EMBED AT 10% KEY EQUAL TO THE STONE PROJECTIONS MINIMUM FINISHED GRADE LAYER WITHOUT SEPARATION. FILL VOIDS WITH STONE OR EQUIVALENT MATERIALS. EXTEND RRAP TO/OVER THE SHOULDER BREAK WHERE APPLICABLE AND TIE INTO ADJACENT TREATMENTS.

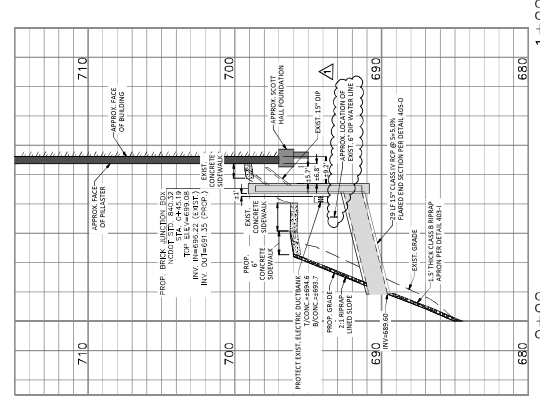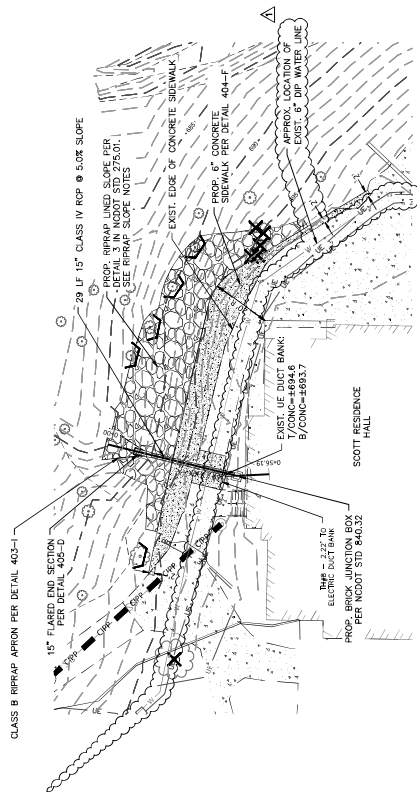

FINAL PLANS - FOR BIDDING  
PURPOSES ONLY  
NOT RELEASED FOR CONSTRUCTION

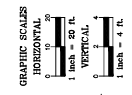

UNIVERSITY COMMENTS	4/7/26	PER UNIVERSITY COMMENTS
REVISION	04/07/26	
DATE	04/07/26	
DATE	JLD	
DATE	RMC	
SCALE	1" = 20'	
PROJECT NO.	#2024-060	
SHEET	C108	

**UNC CHARLOTTE**  
SANITARY SEWER REPAIR AND REPLACEMENT  
(SOUTH VILLAGE)  
SITE RESTORATION  
SCOTT HALL

Cover & Down Engineering, P.L.C.  
7045-15-1500  
License No. PD601

7045-15-1500  
Charlotte, NC 28214  
Cover & Down Engineering, P.L.C.